


BLOCK-1

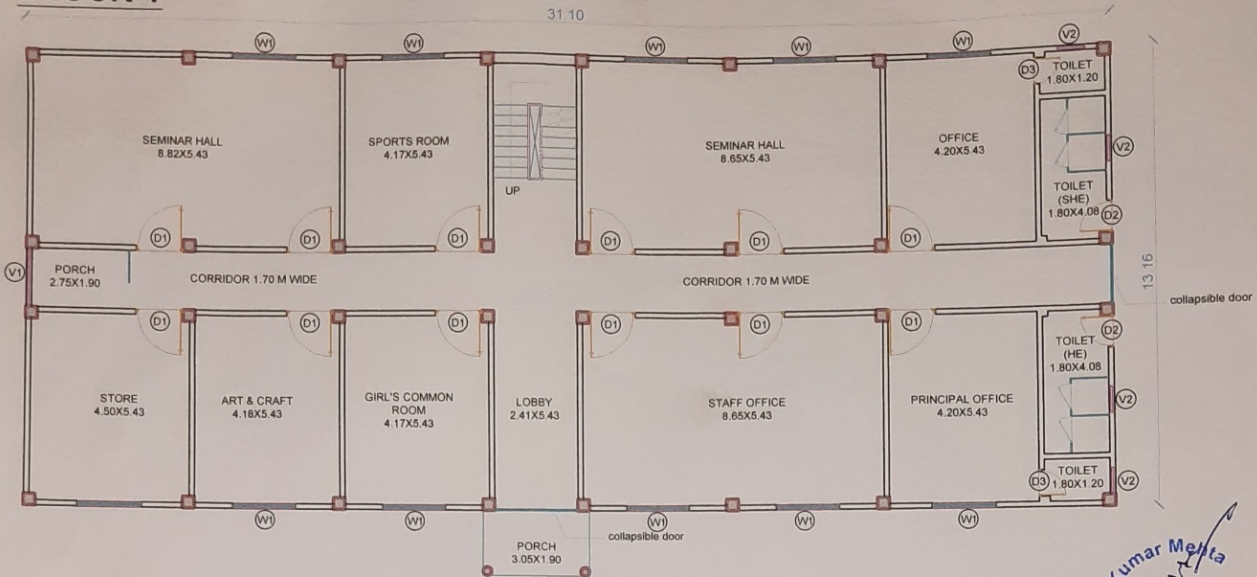

GROUND FLOOR PLAN


(C) Checked that nothing has been changed for
 Preparation of this Drawing
 (D) This drawing has prepared on holiday

Assistant Engineer
 Sub-Division Karsog
 H.P. Mandi
 A. Vajra Kumar Mehta
 CA/2018/104121
 9128633930

SPECIFICATIONS 1. P.C.C. IN FOUNDATION AND PLINTH 2. RCC IN SUPER STRUCTURE 3. BRICK MASONRY IN SUPER STRUCTURE 4. WOODEN FRAME WORK WITH WOODEN SHUTTERS 5. CEMENT PLASTER ON WALLS (INTERNALLY AND EXTERNALLY) 6. FLOORING CEMENT FLOORING 7. PAINTING AND DISTEMPERING ON WALLS	JOINERY DETAIL D1=1.35X2.40 V1 =1.70X0.60 D2 =0.90X1.95 V2 =0.75X0.60 D3 =0.75X1.95 W =1.80X1.80	TITLE AS BUILT DRAWINGS OF BHARWAJ SHIKSHAN SANSTHAN (B.Ed COLLEGE) H.P. MANDI, DISTT. KARSOG, DISTT. MANDI (H.P.)			PREPARED BY H.P. MANDI
NOTES 1. ALL DIMENSIONS ARE IN METERS 2. DRAWING SHOULD BE READ, NOT TO BE MEASURED 3. THIS DRAWING IS NOT TO BE USED, COPIED OR CIRCULATED IN ANY MANNER OTHER THAN THE PURPOSE FOR WHICH IT IS ISSUED	AREA STATEMENT GROUND FLOOR AREA = 409.28 SQM FIRST FLOOR AREA = 409.28 SQM SECOND FLOOR AREA = 409.28 SQM TOTAL BUILT-UP AREA = 1227.84 SQM	SCALE NOT TO SCALE	NORTH 	DATE 19/04/2021	

DECON ASSOCIATES
 TOWER KARSOG, MOBILE
 MANDI (H.P.) +91 941 87 2045
 173011 +91 798 23 18419
 e-mail - deconassociates@gmail.com

BLOCK-1

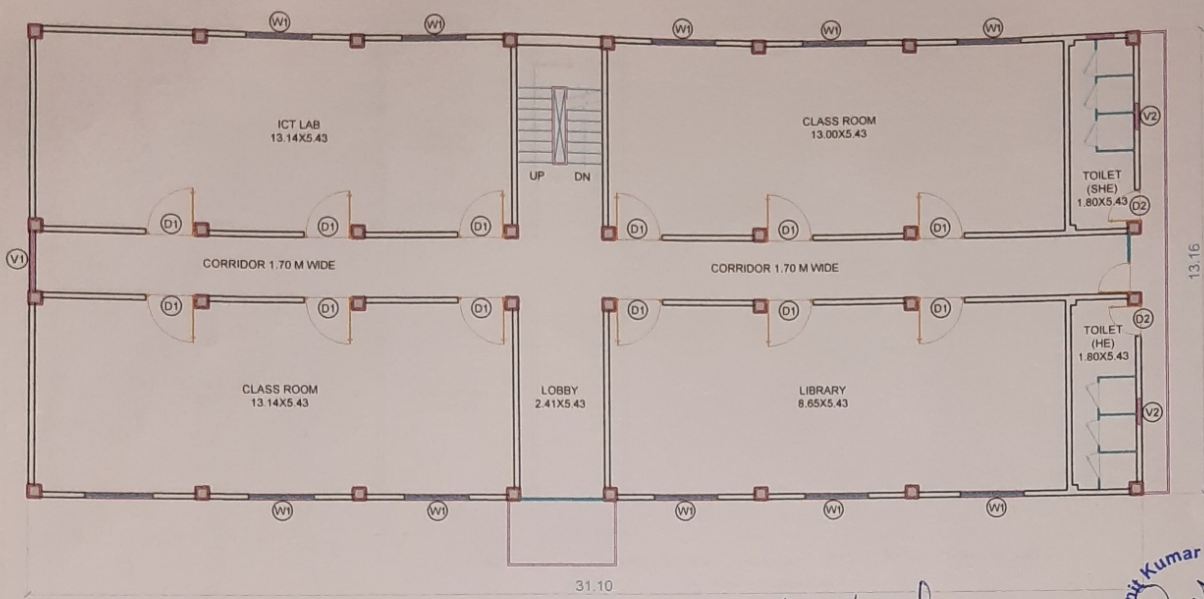

FIRST FLOOR PLAN


(1) Attention that drawing No. Don check for
 (2) I am drawing was prepared on...

A. Vanik Kumar Mehta
 Assistant Engineer
 Ph. No. +91 938 329330

SPECIFICATIONS		JOINERY DETAIL	TITLE	PREPARED BY
1. P.C.C. IN FOUNDATION AND PLINTH 2. RCC IN SUPER STRUCTURE 3. BRICK MASONRY IN SUPER STRUCTURE 4. WOODEN FRAME WORK WITH WOODEN SHUTTERS 5. CEMENT PLASTER ON WALLS (INTERNALLY AND EXTERNALLY) 6. FLOORING: CEMENT FLOORING 7. PAINTING AND DISTEMPERING ON WALLS		D1 = 1.35x2.40 V1 = 1.70x0.60 D2 = 0.90x1.55 V2 = 0.75x0.60 D3 = 0.75x1.55 W = 1.80x1.80	AS BUILT DRAWINGS OF HPPWD Karsog BHARDWAJ SHIKSHAN SANSTHAN (B.Ed COLLEGE) AT KARSOG, TEHSIL KARSOG, DISTT. MANDI (H.P.) HPPWD Section	Sub. Division Karsog Ph. No. +91 938 329330
NOTES		AREA STATEMENT	SCALE	NORTH
1. ALL DIMENSIONS ARE IN METERS 2. DRAWING SHOULD BE READ, NOT TO BE MEASURED 3. THIS DRAWING IS NOT TO BE USED, COPIED OR CIRCULATED IN ANY MANNER OTHER THAN THE PURPOSE FOR WHICH IT IS ISSUED		GROUND FLOOR AREA = 409.28 SQM FIRST FLOOR AREA = 409.28 SQM SECOND FLOOR AREA = 409.28 SQM TOTAL BUILT-UP AREA = 1227.84 SQM	NOT TO SCALE	DATE: 19/04/2021 NORTH: [Compass rose pointing North]

D E CON ASSOCIATES
 OFFICE: KARSOG, MANDI (H.P.)
 PHONE: +91 941 87 72045
 +91 996 23 18419
 E-MAIL: dconassociates@gmail.com

BLOCK-1

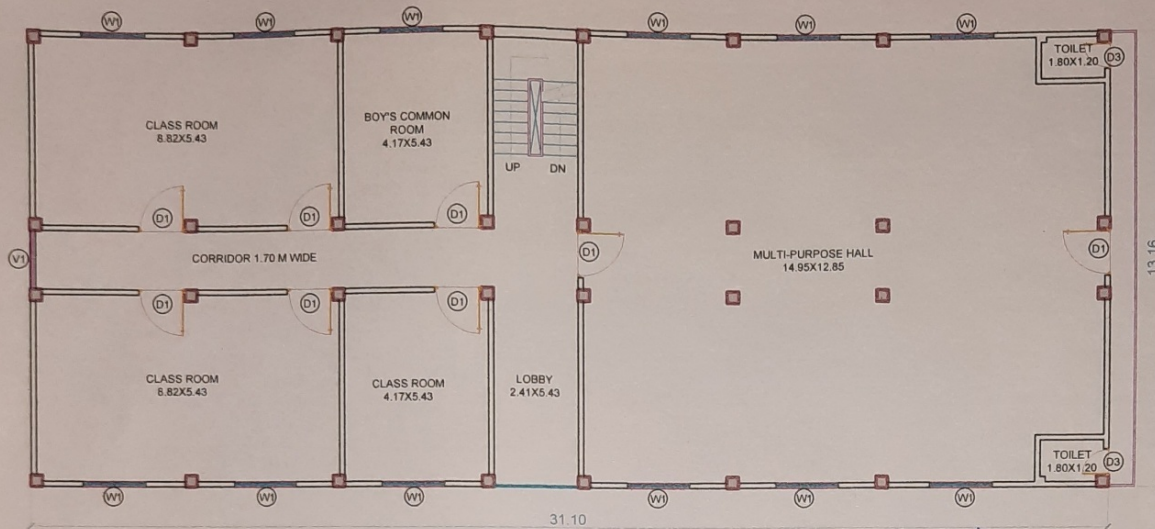

certified condition that nothing has been changed after preparation of this drawing
(Signature) Assistant Engineer

Ar. Vanit Kumar Mehta
(Signature)
 CR/2018/104121
 No. 101 91366-33930

SECOND FLOOR PLAN

SPECIFICATIONS	JOINERY DETAIL	TITLE	PREPARED BY
1. P.C.C. IN FOUNDATION AND PLINTH 2. RCC IN SUPER STRUCTURE 3. BRICK MASONRY IN SUPER STRUCTURE 4. WOODEN FRAME WORK WITH WOODEN SHUTTERS 5. CEMENT PLASTER ON WALLS (INTERNALLY AND EXTERNALLY) 6. FLOORING- CEMENT FLOORING 7. PAINTING AND DISTEMPERING ON WALLS	D1=1.35X2.40 V1 =1.70X0.80 D2 =0.90X1.55 V2 =0.75X0.60 D3 =0.75X1.95 W =1.80X1.80	Junior Engineer AS BUILT DRAWINGS OF BHARDWAJ SHIKSHAN SANSTHAN (B.E.U COLLEGE) AT KARSOG, TEHSIL KARSOG, DISTT. MANDI (H.P.)	Sub. Division Karsog Ar. Vanit Kumar Mehta CR/2018/104121
NOTES	AREA STATEMENT	SCALE	NORTH DATE
1. ALL DIMENSIONS ARE IN METERS 2. DRAWING SHOULD BE READ, NOT TO BE MEASURED 3. THIS DRAWING IS NOT TO BE USED, COPIED OR CIRCULATED IN ANY MANNER OTHER THAN THE PURPOSE FOR WHICH IT IS ISSUED	GROUND FLOOR AREA = 409.28 SQM FIRST FLOOR AREA = 409.28 SQM SECOND FLOOR AREA = 409.28 SQM TOTAL BUILT-UP AREA = 1227.84 SQM	NOT TO SCALE	NORTH 19/04/2021

DECON ASSOCIATES

JOYDEVI KARSOG, MANDI (H.P.)
 TEL: 91 1941 87 72645
 MOBILE: 91 9846 23 18018
 e-mail - deconassociates@gmail.com