


# BLOCK-2

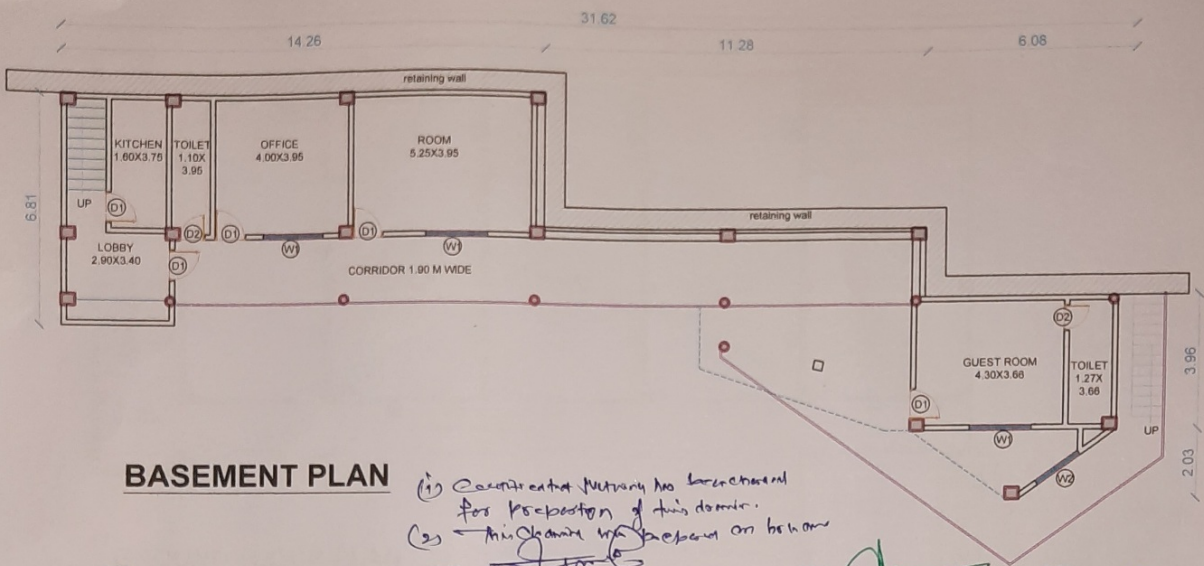

## BASEMENT PLAN

(1) Concentrated masonry has been checked for proportion of this domain.  
 (2) This drawing is prepared on below


Junior Engineer  
 H P P W D Section  
 Karsog-I

Assistant Engineer  
 Sub-Division Karsog  
 H P P W D Karsog

Vijay Kumar Mehta  
 19/04/2021

SPECIFICATIONS	JOINERY DETAIL	TITLE			PREPARED BY
1. P.C.C. IN FOUNDATION AND PLINTH 2. RCC IN SUPER STRUCTURE 3. BRICK MASONRY IN SUPER STRUCTURE 4. WOODEN FRAME WORK WITH WOODEN SHUTTERS 5. CEMENT PLASTER ON WALLS (INTERNALLY AND EXTERNALLY) 6. FLOORING, CEMENT FLOORING 7. PAINTING AND DISTEMPERSING ON WALLS	D1 = 0.90x2.50 V1 = 1.80x0.50 D2 = 0.75x2.10 W1 = 1.80x1.80 W2 = 1.50x1.80	AS BUILT DRAWINGS OF BHARDWAJ SHIKSHAN SANSTHAN (B.Ed COLLEGE) AT KARSOG, TEHSIL KARSOG, DISTT. MANDI (H.P.)			D. CON ASSOCIATES FORK KARSOG, MANDI (H.P.) MOBILE: +91 941 87 72045 +91 799 23 14419 e-mail: deconassociates@gmail.com
NOTES 1. ALL DIMENSIONS ARE IN METERS 2. DRAWING SHOULD BE READ, NOT TO BE MEASURED 3. THIS DRAWING IS NOT TO BE USED, COPIED OR CIRCULATED IN ANY MANNER OTHER THAN THE PURPOSE FOR WHICH IT IS ISSUED.	AREA STATEMENT BASEMENT AREA = 138.58 SQM GROUND FLOOR AREA = 461.94 SQM FIRST FLOOR AREA = 466.70 SQM TOTAL BUILT-UP AREA = 1067.22 SQM		SCALE NOT TO SCALE	NORTH 	DATE 19/04/2021

**BLOCK-2**

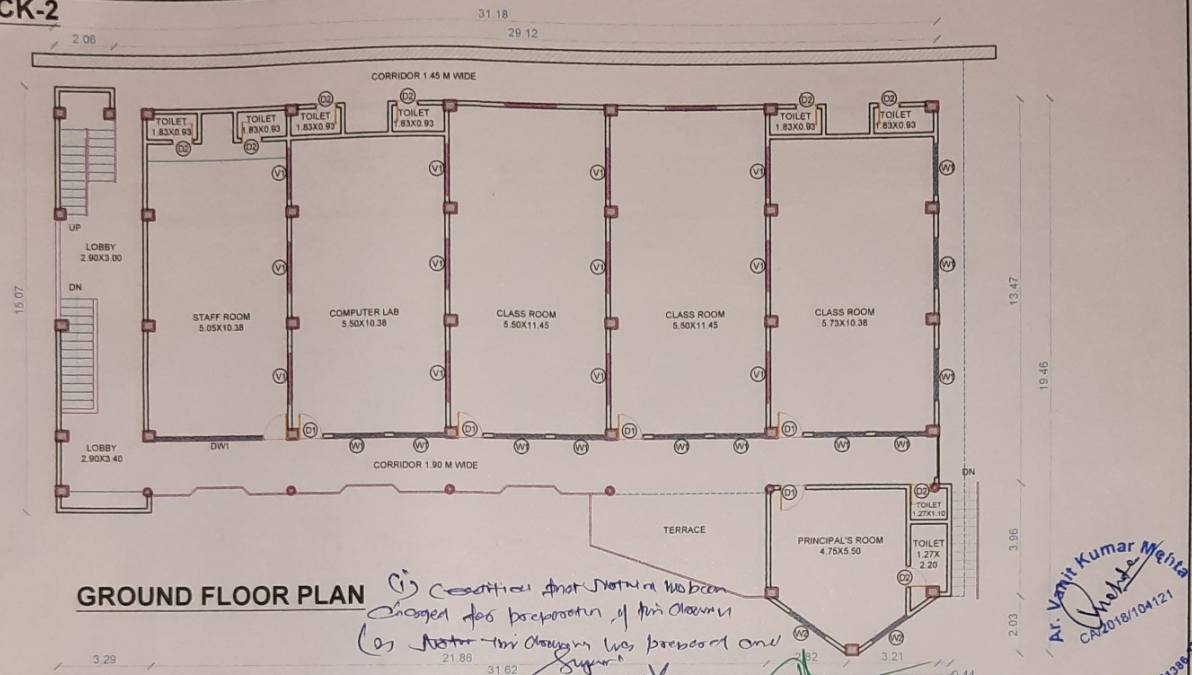

**GROUND FLOOR PLAN**

*As condition that not to be changed the preparation of this drawing as not to change was prepared and signed*


*Ar. Vanit Kumar Mehta  
Maha  
CA/2018/104121  
Ph. No. 91 91388 9389*

<p><b>SPECIFICATIONS</b></p> <ol style="list-style-type: none"> <li>P.C.C. IN FOUNDATION AND PLINTH</li> <li>RCC IN SUPER STRUCTURE</li> <li>BRICK MASONRY IN SUPER STRUCTURE</li> <li>WOODEN FRAME WORK WITH WOODEN SHUTTERS</li> <li>CEMENT PLASTER ON WALLS (INTERNALLY AND EXTERNALLY)</li> <li>FLOORING CEMENT FLOORING</li> <li>PAINTING AND DISTEMPERING ON WALLS</li> </ol>	<p><b>JOINERY DETAIL</b></p> <p>D1 = 0.80x2.50 D2 = 0.75x2.10 W1 = 1.80x1.80 W2 = 1.50x1.80</p> <p>V1 = 1.80x0.80</p>	<p><b>TITLE</b></p> <p><b>Junior Engineer</b> <b>AS BUILT DRAWINGS OF Division Karsog</b> <b>BHARDWAJI SHIKSHA SAHAYAN (B.E.U. COLLEGE)</b> <b>AT KARSOG, TEHSIL KARSOG, DISTT. MANDI (H.P.)</b></p>	<p><b>PREPARED BY</b></p> <p><b>Ar. Vanit Kumar Mehta</b></p>	
<p><b>NOTES</b></p> <ol style="list-style-type: none"> <li>ALL DIMENSIONS ARE IN METERS</li> <li>DRAWING SHOULD BE READ, NOT TO BE MEASURED</li> <li>THIS DRAWING IS NOT TO BE USED, COPIED OR CIRCULATED IN ANY MANNER OTHER THAN THE PURPOSE FOR WHICH IT IS ISSUED</li> </ol>	<p><b>AREA STATEMENT</b></p> <p>BASEMENT AREA = 158.56 SQM GROUND FLOOR AREA = 481.94 SQM FIRST FLOOR AREA = 466.70 SQM TOTAL BUILT-UP AREA = 1087.22 SQM</p>	<p><b>SCALE</b></p> <p>NOT TO SCALE</p>	<p><b>NORTH</b></p> <p>N</p>	<p><b>DATE</b></p> <p>19/04/2021</p>

**DECON ASSOCIATES**

OFFICE: KARSOG, MANDI (H.P.)  
PHONE: +91 941 87 2044  
MOBILE: +91 941 87 2044  
E-MAIL: deconassociates@gmail.com

# BLOCK-2

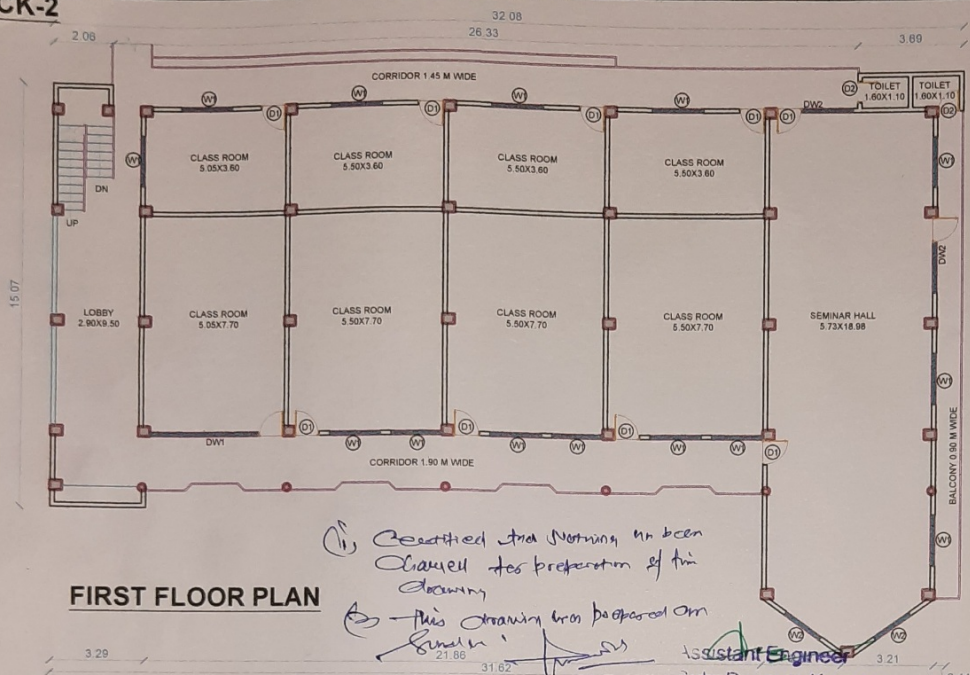

## FIRST FLOOR PLAN

1) Checked and verified, has been cleared for preparation of this drawing  
 2) This drawing has been prepared on  
 19/04/2021  
 Assistant Engineer  
 Sub Division Karsog

Ar. Vajrikumar Mehta  
 CA/2018/104121  
 No. 191/9146-29829

<b>SPECIFICATIONS</b> 1. P.C.C. IN FOUNDATION AND PLINTH 2. RCC IN SUPER STRUCTURE 3. BRICK MASONRY IN SUPER STRUCTURE 4. WOODEN FRAME WORK WITH WOODEN SHUTTERS 5. CEMENT PLASTER ON WALLS (INTERNALLY AND EXTERNALLY) 6. FLOORING: CEMENT FLOORING 7. PAINTING AND DISTEMPERING ON WALLS	<b>JOINERY DETAIL</b> D1 = 0.90x2.50 V1 = 1.80x0.50 D2 = 0.75x2.10 W1 = 1.80x1.80 W2 = 1.50x1.80	<b>TITLE</b> Junior Engineer AS-BUILT DRAWINGS OF <b>BHARDWAJ SHIKSHAN SANSTHAN (B.Ed COLLEGE)</b> AT KARSOG, TEHSIL KARSOG, DISTT. MANDI (H.P.)	<b>PREPARED BY</b> Ar. Vajrikumar Mehta No. 191/9146-29829	
<b>NOTES</b> 1. ALL DIMENSIONS ARE IN METERS 2. DRAWING SHOULD BE READ, NOT TO BE MEASURED 3. THIS DRAWING IS NOT TO BE USED, COPIED OR CIRCULATED IN ANY MANNER OTHER THAN THE PURPOSE FOR WHICH IT IS ISSUED	<b>AREA STATEMENT</b> BASEMENT AREA = 158.58 SQM GROUND FLOOR AREA = 461.94 SQM FIRST FLOOR AREA = 486.70 SQM TOTAL BUILT-UP AREA = 1087.22 SQM	<b>SCALE</b> NOT TO SCALE	<b>NORTH</b> 	<b>DATE</b> 19/04/2021
<b>DECON ASSOCIATES</b> JOHAR KARSOG, MANDI (H.P.) MOBILE: +91 941 87 2045 +91 998 23 10419 E-mail: deconassociates@gmail.com				